


ONE BELLEVUE

411 108TH AVENUE NE, BELLEVUE, WA

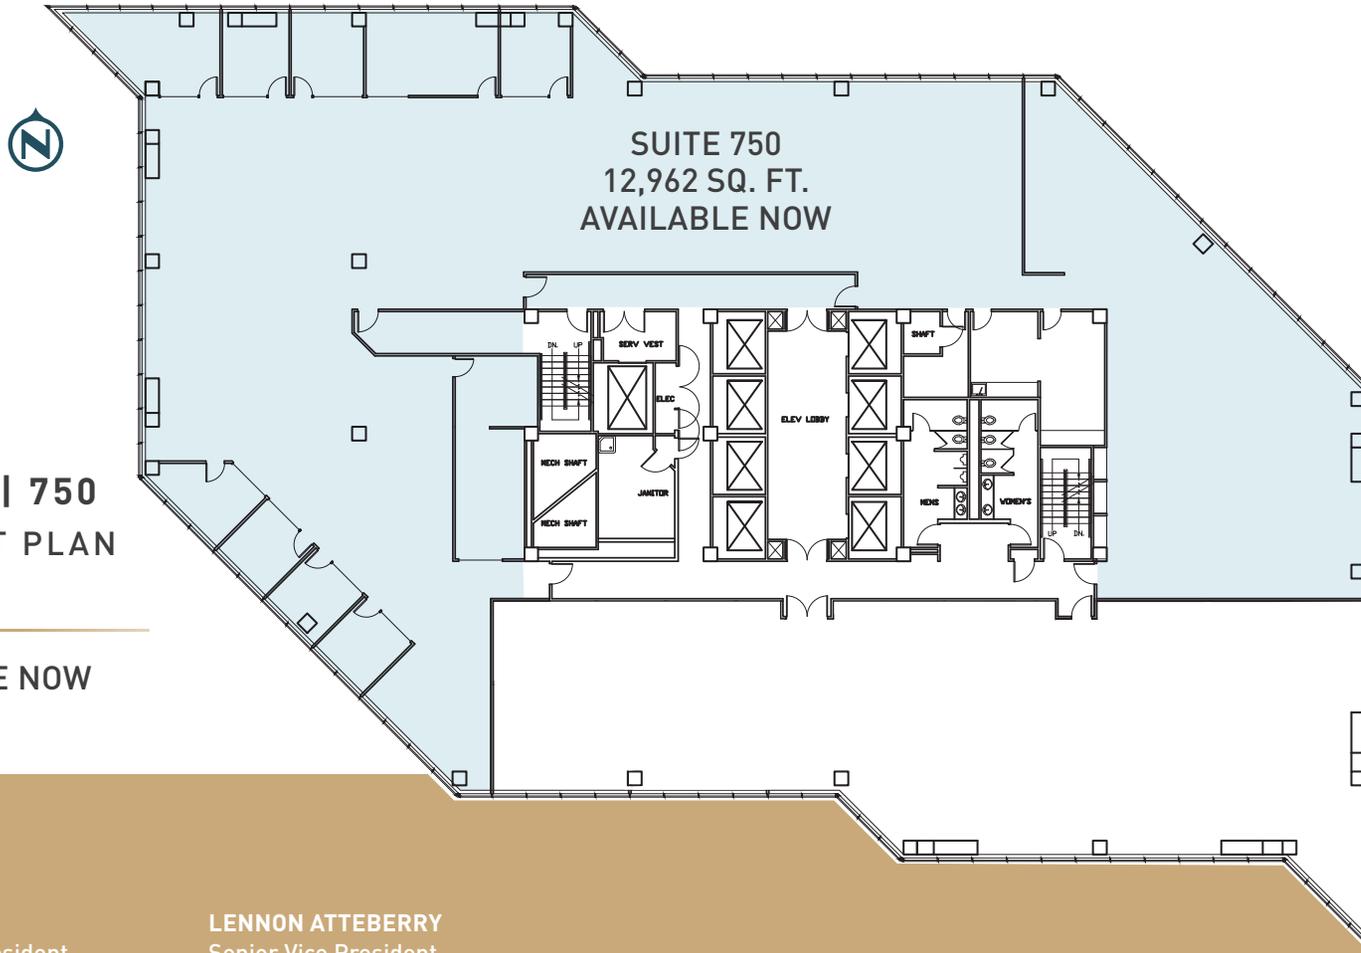

FLOOR 7
SUITES | 750
AS-BUILT PLAN

AVAILABLE NOW

SUITE 750
VIRTUAL TOUR 


TIM OWENS
Senior Vice President
+1 425 462 6913
tim.owens@cbre.com

LENNON ATTEBERRY
Senior Vice President
+1 425 941 7633
lennon.attedberry@cbre.com

 LaSalle™ **CBRE**

ONE BELLEVUE

411 108TH AVENUE NE, BELLEVUE, WA

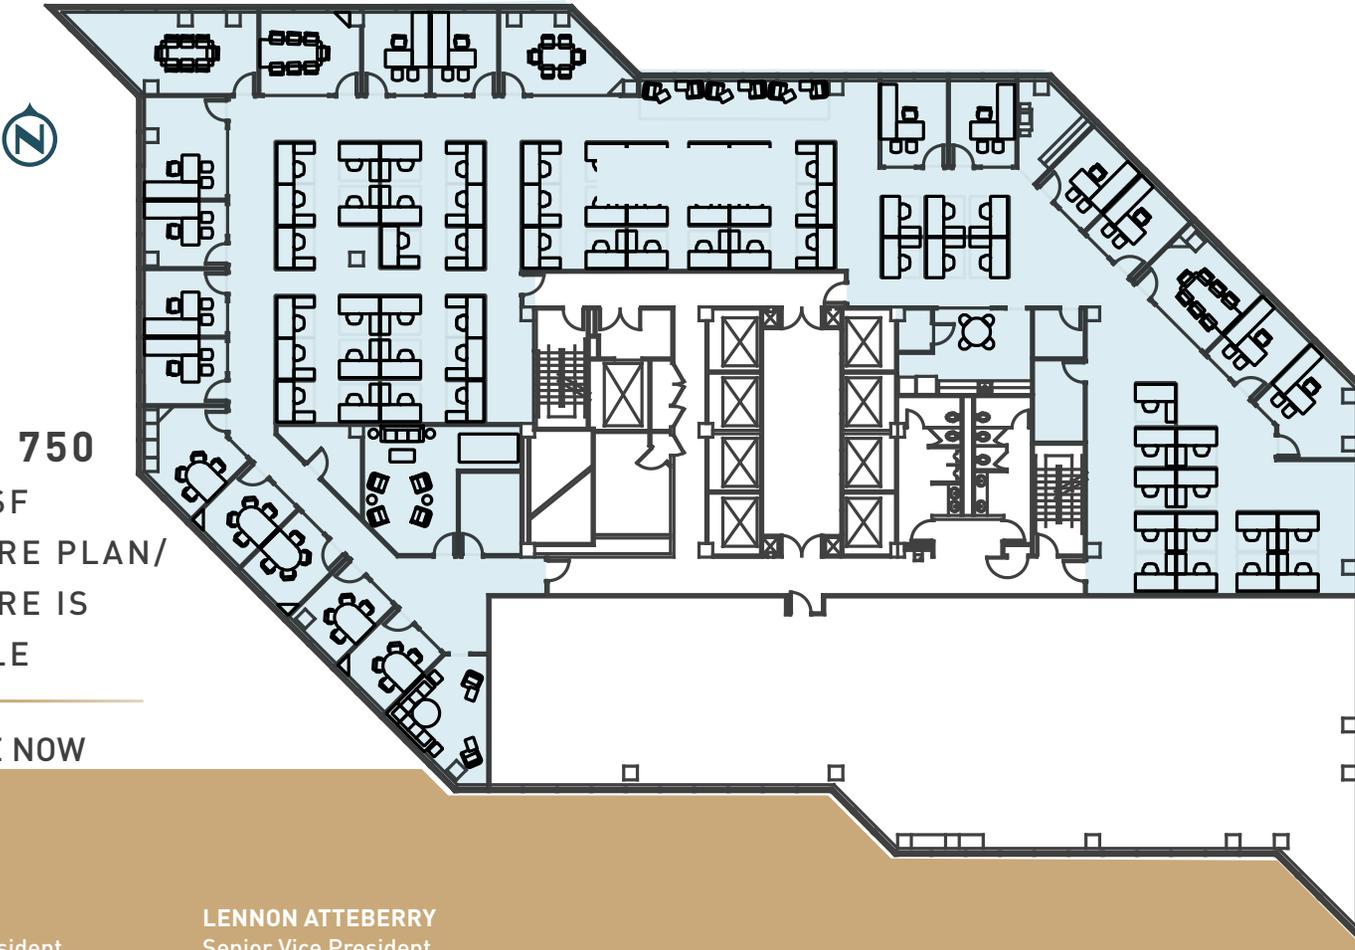

FLOOR 7

SUITE | 750

12,962 RSF

FURNITURE PLAN/
FURNITURE IS
AVAILABLE

AVAILABLE NOW

SUITE 750
VIRTUAL TOUR 

TIM OWENS
Senior Vice President
+1 425 462 6913
tim.owens@cbre.com

LENNON ATTEBERRY
Senior Vice President
+1 425 941 7633
lennon.attedberry@cbre.com

 LaSalle™ **CBRE**